
With further reference to the proposed grant of a further licence of land for a community garden at the rear of Summer Street North, Dublin 1.

Council Report No. 20 of 2017 which was assented to by the Dublin City Council at its monthly meeting held on 9th January 2017, approved terms and conditions for the grant of a further licence of land for a community garden at the rear of Summer Street North, Dublin 1 which is more particularly delineated on Map Index 17505 to Mr. Barry McGee on behalf of the Summer Street North Residents Committee.

The legal formalities have not yet completed and the Law Department has advised that the group have confirmed that Mr. McGee is no longer involved with the group.

Accordingly it is proposed that Council Report No. 20 of 2017 be amended insofar as it relates to the name of the licensee and to grant the letting in the name of Daniele Ponzo on behalf of Summer Street North Residents Committee.


The dates for the performance of any of the requirements of the proposed disposal may be amended at the absolute discretion of the Executive Manager.

The proposed disposal shall be subject to such conditions as to title to be furnished, as the Law Agent in his discretion shall stipulate.

No agreement enforceable at law is created or intended to be created until an exchange of contracts has taken place.

Dated this the 11th day of July 2017


Paul Clegg
Executive Manager

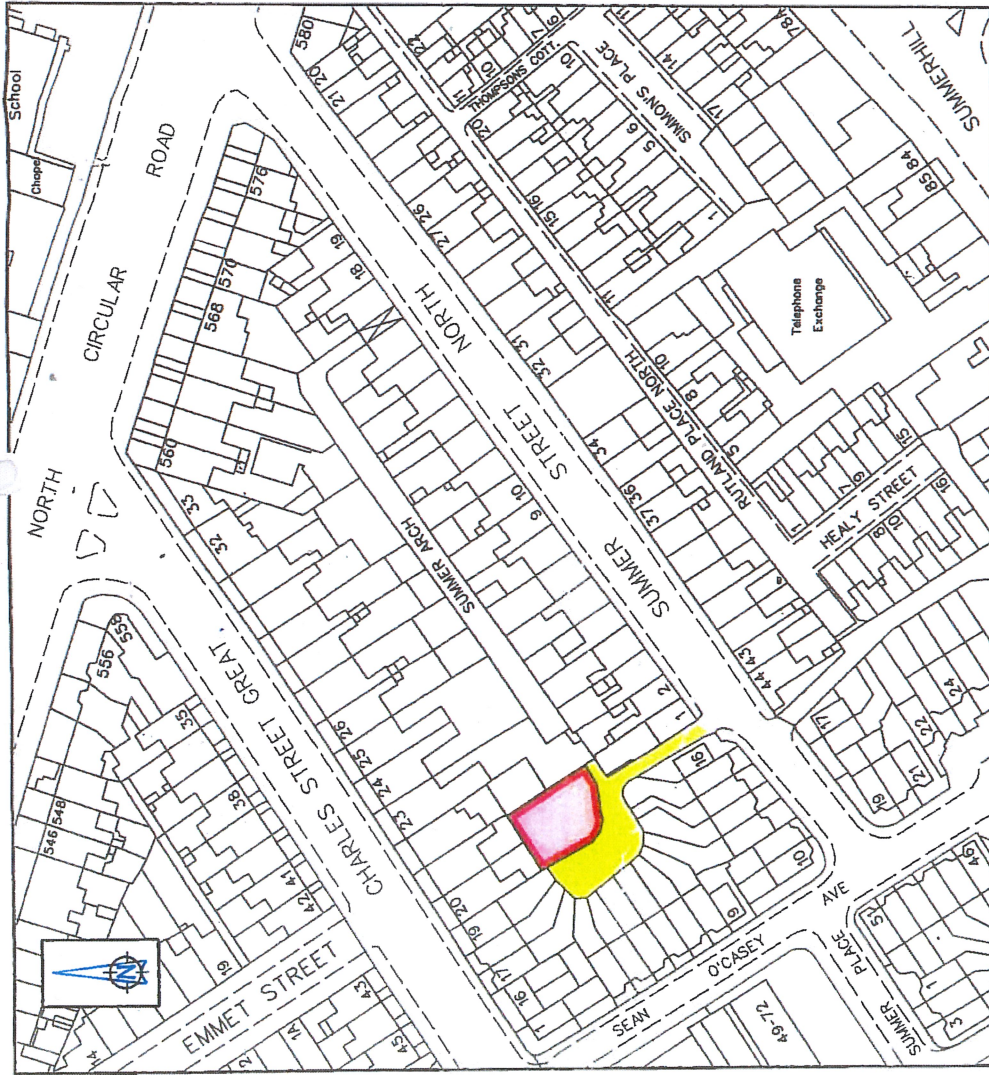


LOCATION MAP Scale 1:1000

LAND AT REAR OF SUMMER STREET NORTH
 2 YEAR LICENCE TO ~~KEVIN DOWNEY~~ DANIELE BARD
 AND ~~GARYAN GALLAGHER~~
 BEHALF OF THE SUMMER STREET NORTH RESIDENTS COMMITTEE

LICENCE AREA 
 ACCESS TO LICENCE AREA 

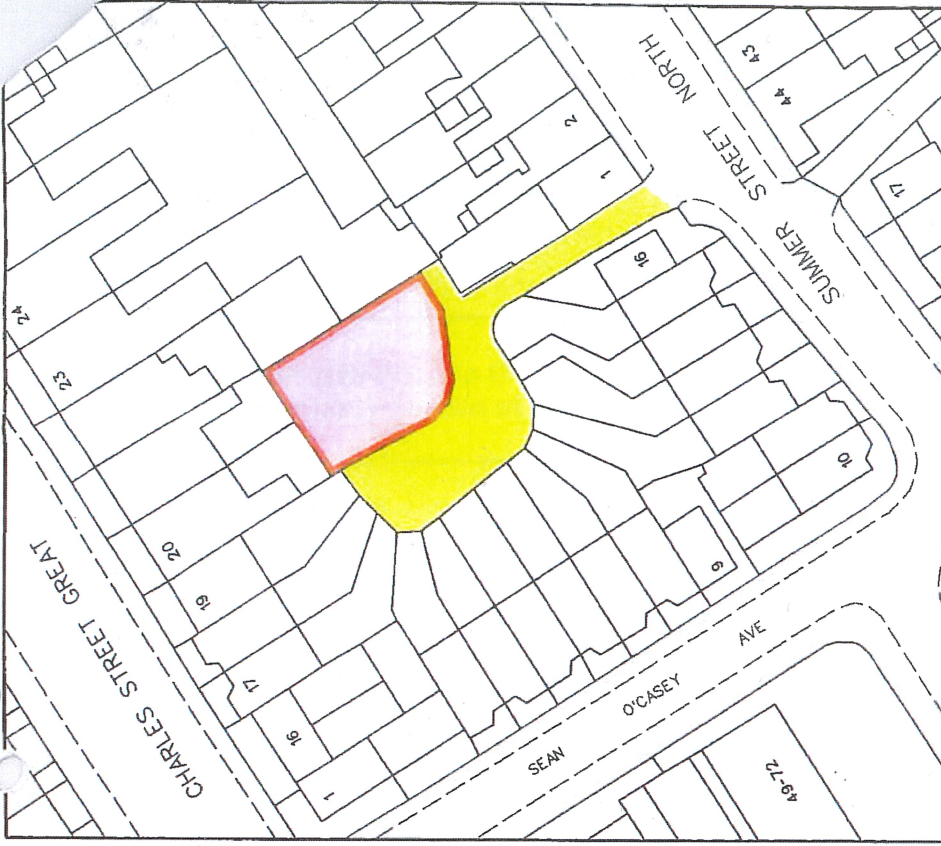

ENLARGEMENT Scale 1:500



DUBLIN CITY COUNCIL
 Comhairle Cathrach Bhaile Atha Cliath
 ENVIRONMENT AND ENGINEERING DEPARTMENT
 An Roinn Comhshaoil agus Innealtóireachta
 SURVEY AND MAPPING SERVICES DIVISION
 Rannán Seirbhíse Suirbhíreachta agus Léarscálithe

SCALE INDEX No.
1:500 **17505**
1:1000
CODE C. 27

M. PHILLIPS
 CITY ENGINEER

FC
 SURVEYED / MADE BY
 DATE 04-11-2009
If OSI data included : © Ordnance Survey Ireland. All rights reserved. Licence Number 2009 070004/Dublin City Council