

To the Lord Mayor and
Members of Dublin City Council

Report No. 234/2020
Report of the Senior Executive Officer



With further reference to the proposed grant of a lease of a site for a substation in a Block E, Thornton Heights, St. Michael's Estate, Inchicore Dublin 8 to the Electricity Supply Board.


Report No. 156/2012 which was assented to by the City Council at its meeting on 14th May 2012 approved the grant of a 99 year lease of a substation site in Block E, Thornton Heights, St Michael's Estate, Inchicore, Dublin 8 to the ESB.

The legal formalities have not yet been completed and the Survey and Mapping Division has now advised that the substation was built as shown outlined in red on map index number SM-2020-0348-001, approximately 3.8 metres north to as shown coloured red on original map index number SM-2012-152.

Accordingly, it is proposed to vary Report No. 156/2020 assented to by the City Council at its meeting on 14th May 2012 insofar as it relates to the correct location of the substation and to complete this disposal with the location shown outlined in red on map index number SM-2020-0348-001.

This report is submitted in accordance with the requirements of Section 183 of the Local Government Act, 2001.

Helen McNamara
Senior Executive Officer
14th August 2020

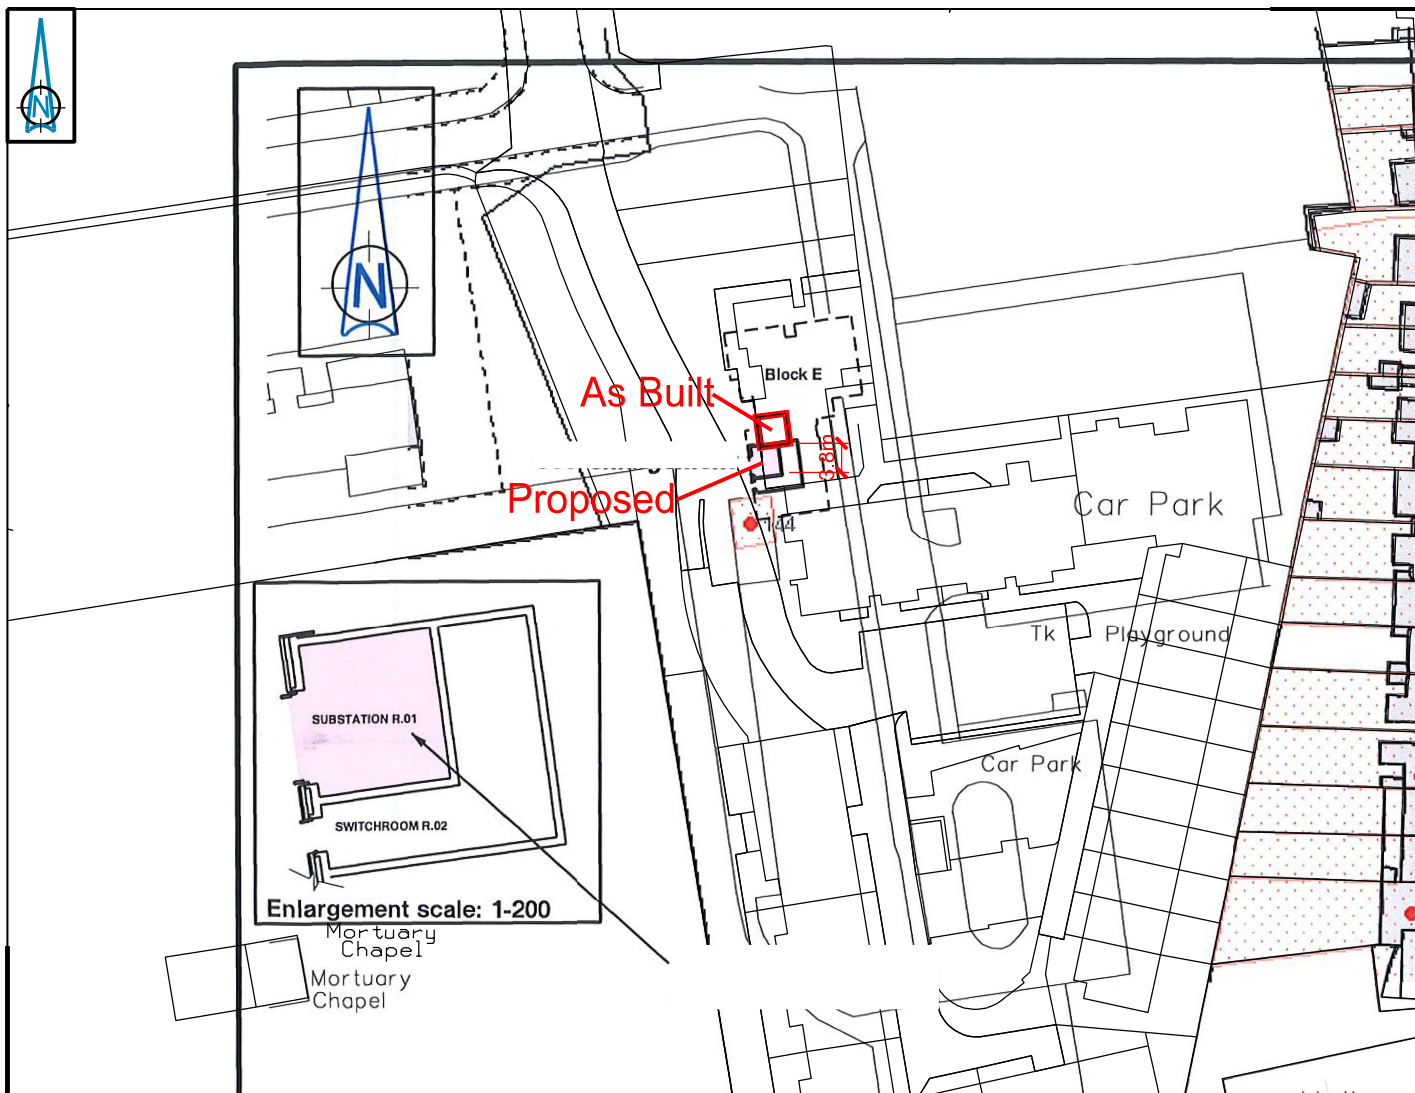

Thornton Heights, St. Michael's Estate

Dublin City Council to E.S.B.

Map for Information Purposes Only



Comhairle Cathrach
Bhaile Átha Cliath
Dublin City Council

An Roinn Comhshaoil agus Iompair
Rannán Suirbhéireachta agus Léarscáilithe
Environment and Transportation Department
Survey and Mapping Division

O.S REF
3263-11/16

SCALE
1:1000

DATE
14-08-20

SURVEYED /
PRODUCED BY
E Ging

FILE NO

INDEX No
DWG No
REV
F:\SM-2020-0391 - 001 - A.dgn

THIS MAP IS CERTIFIED TO BE COMPUTER GENERATED BY
DUBLIN CITY COUNCIL FROM ORDNANCE SURVEY DIGITAL MAPBASE

SURVEY, MAPPING AND RELATED RESEARCH APPROVED

APPROVED

THOMAS CURRAN

ACTING MANAGER LAND SURVEYING & MAPPING
DUBLIN CITY COUNCIL

Dr JOHN W. FLANAGAN

CEng FIEI FICE
CITY ENGINEER

INDEX No.

SM-2020-0391-001